


The diagram shows a circular structure on the left and a table on the right. The circular structure has a cross-section with four points marked by circles. The table has four columns and four rows. The columns are labeled 1, 1, 3, and 2 from left to right. The rows are labeled 1, 2, 3, and 4 from top to bottom. The table contains the following data:

1	1	3	2
1	1	3	2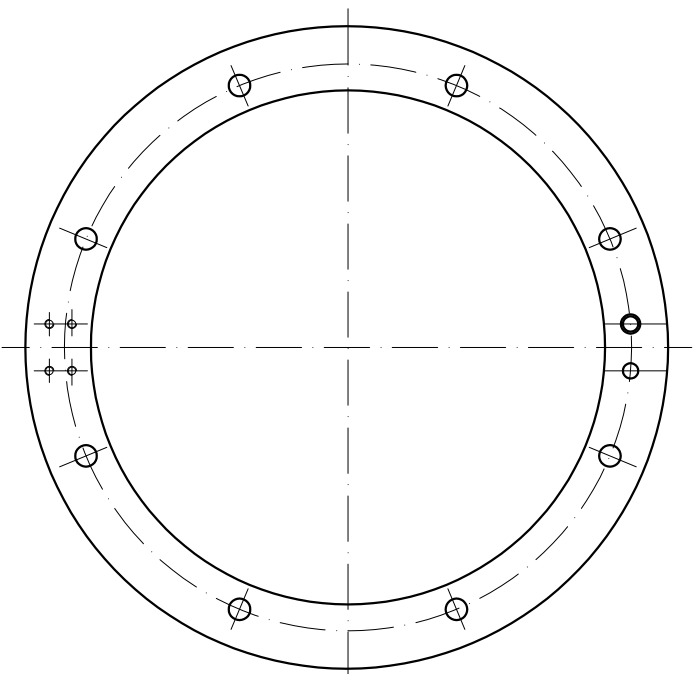
**AS BUILT DOCUMENTATION**

[illegible]